


KENT COUNTY CHILDREN'S HOME

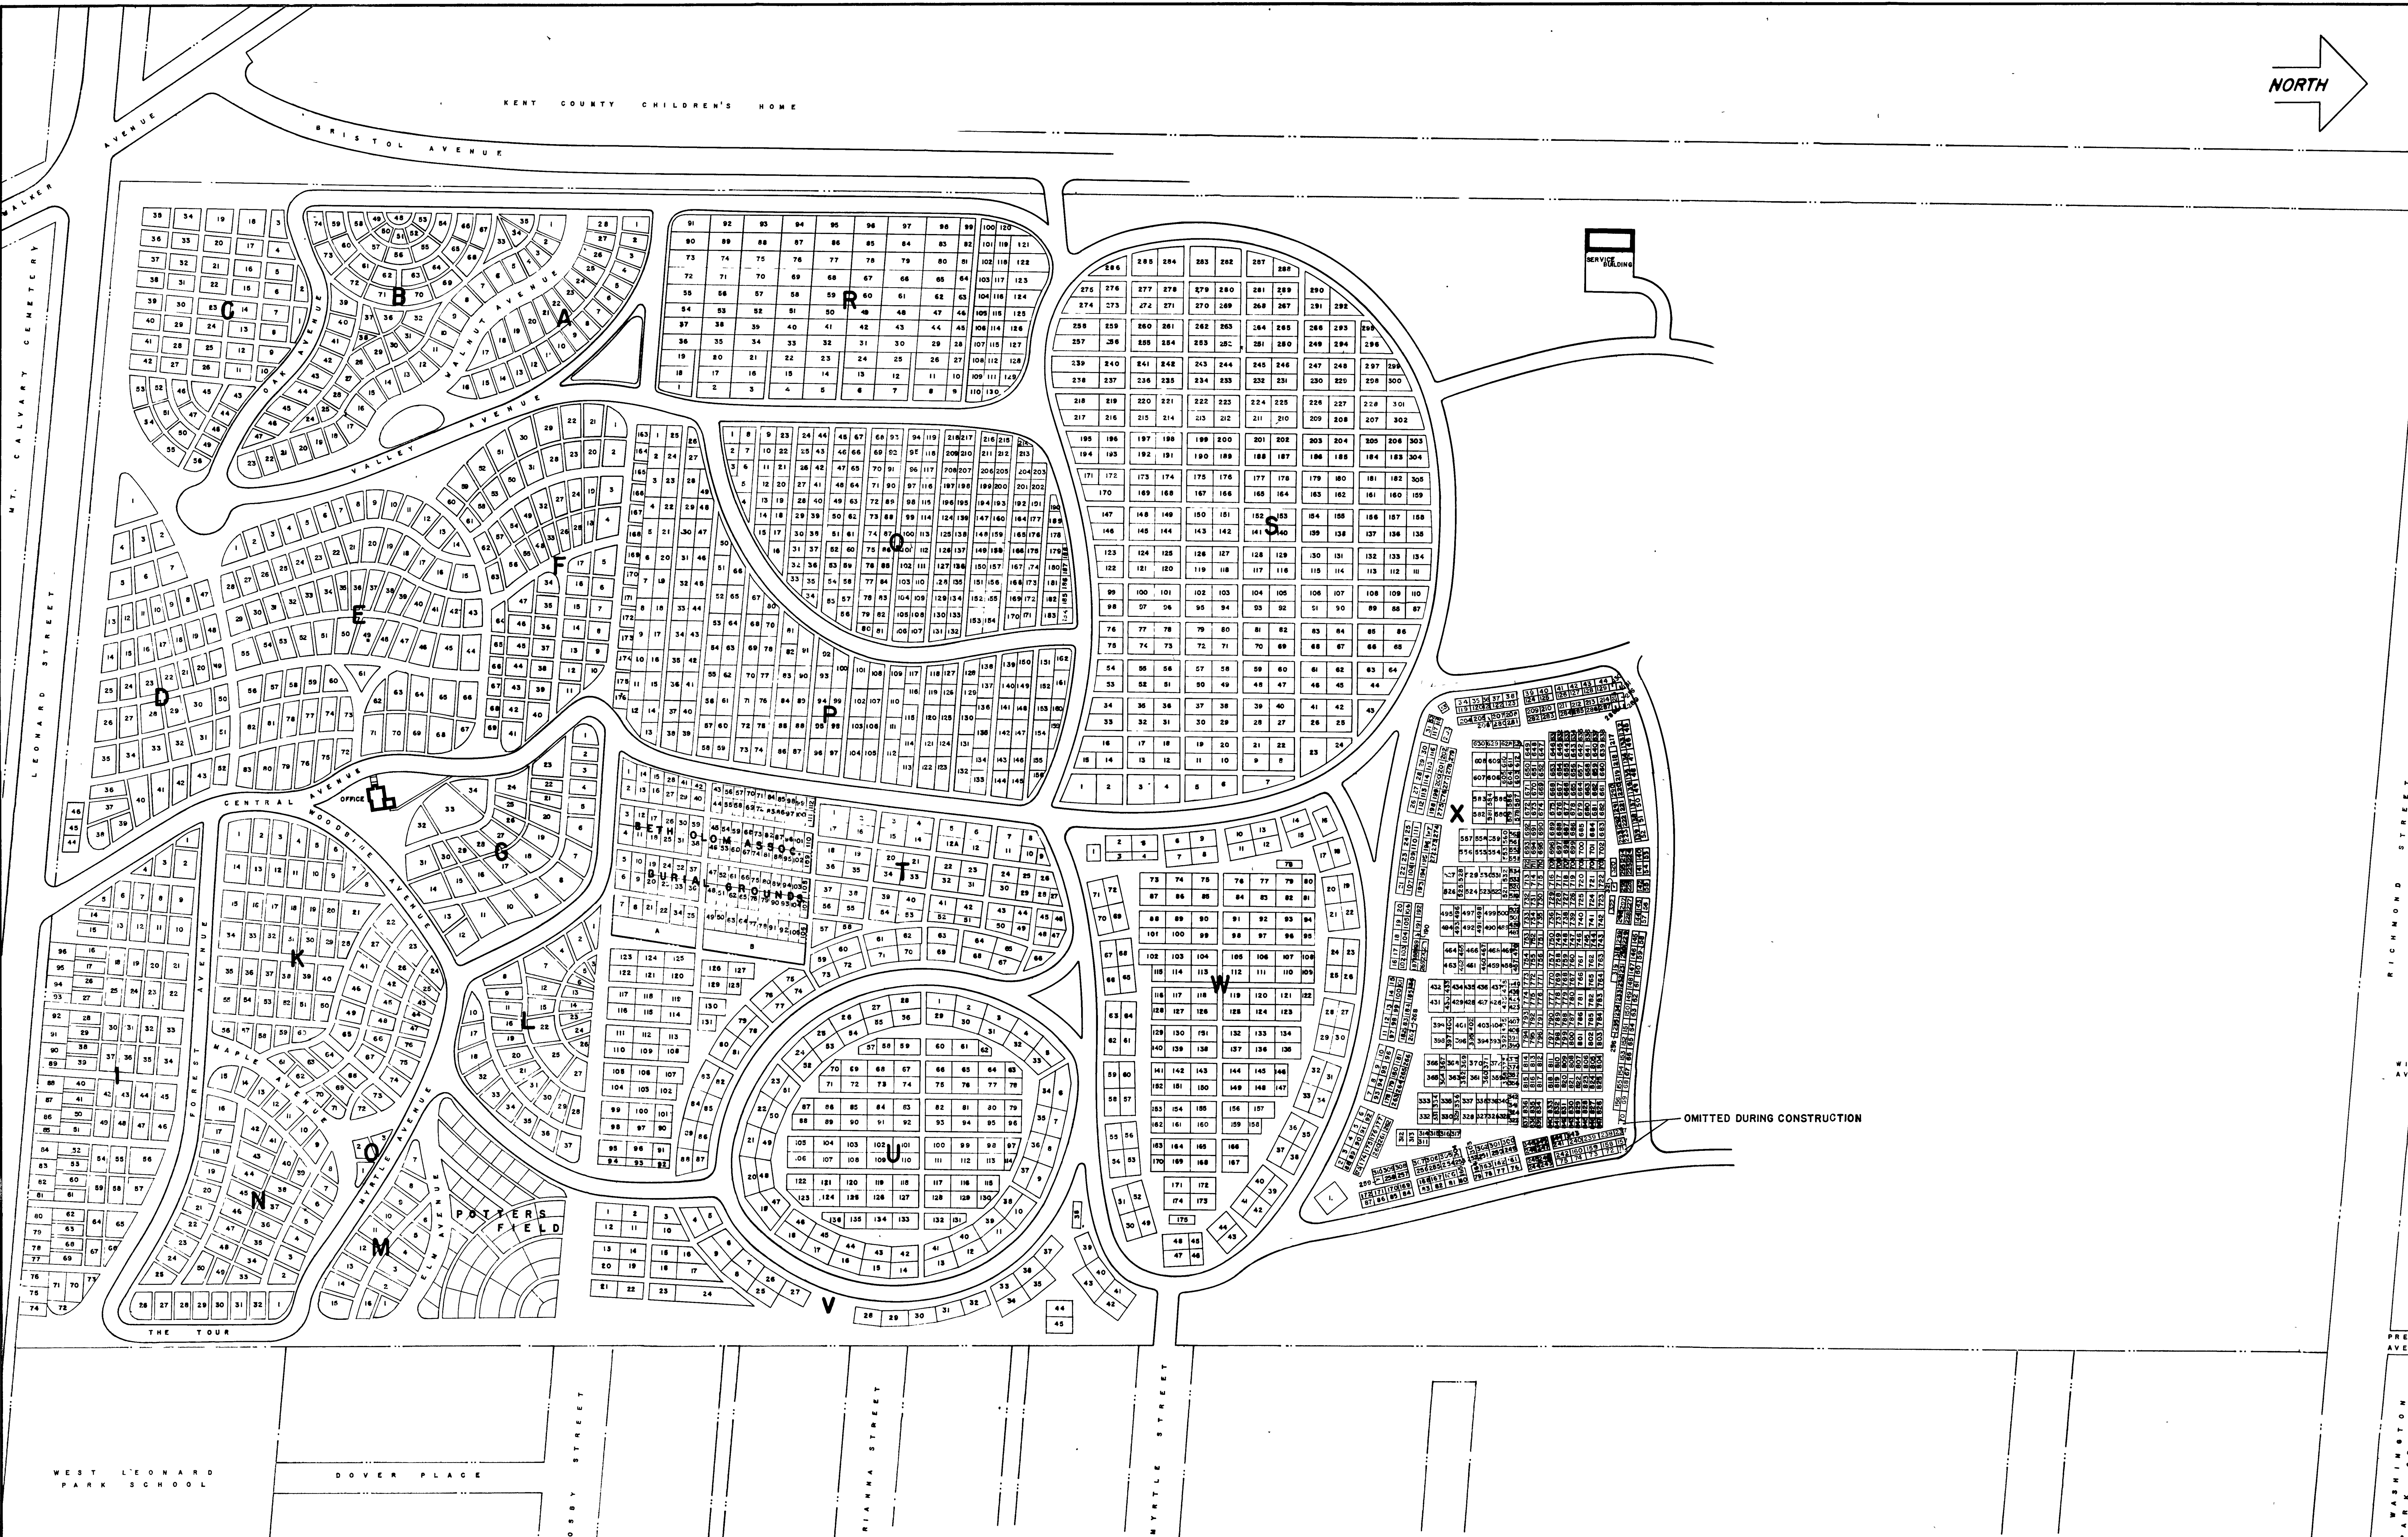

CITY OF GRAND RAPIDS, MICHIGAN — DEPARTMENT OF PARKS

APPROVED BY Supt. of Parks _____ City Manager _____	DATE _____ DATE _____	DRAWN BY: J.A.P.	DATE: 5-2-56	REVISIONS	DATE	BY	GREENWOOD CEMETERY GENERAL PLAN	SHEET 1 OF 1 SCALE 1"=80'
		CHECKED BY _____	DATE _____	AS BUILT: NW & SW RAD., NE RAD., LOTS 70 & 71 REVISED BLOCK "X"	12-13-72	S.H.P.		